USGS monitoring well site at El Toyon Park (ETPK)

As built 9/15/03
2-inch PVC wells
DTW as of 9/14/03
LSD = 109 (topo)

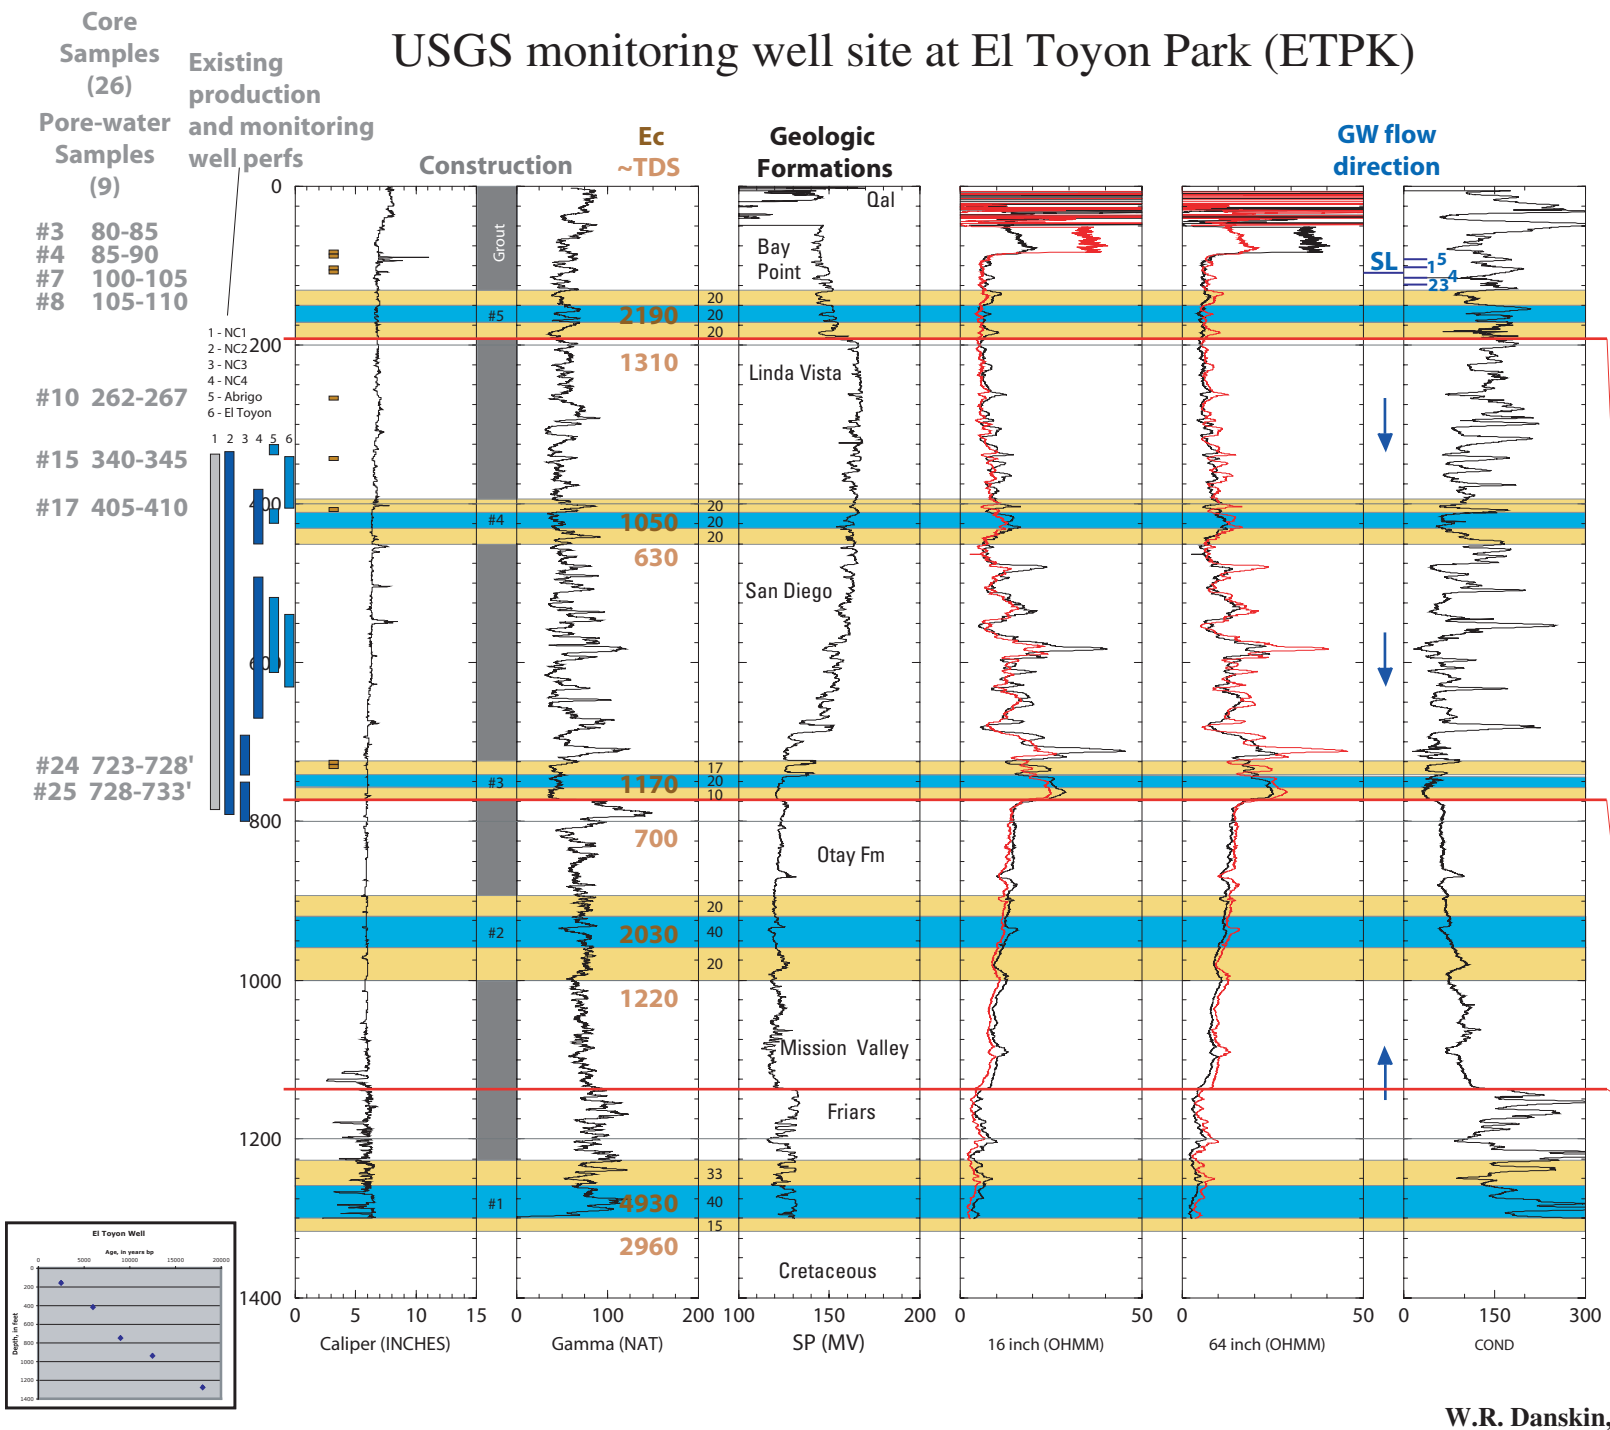

#5 (Water table)
Perfs 150-170
Sand 130-190
DTW = 92.83
WL = 16.17
Age = ? > 50

#4 (Top of production)
Perfs 410-430
Sand 393-450
DTW = 115.78
WL = -6.78
Age = 6,000

#3 (Basal unit, above clay)
Perfs 740-760
Sand 723-770 (10' only)
DTW = 124.00
WL = -15.00
Age = 9,000

#2 (Confining member)
Perfs 920-960 (40 feet)
Sand 872-1000
DTW = 123.80
WL = -14.80
Age = 12,500

formation boundaries

#1 (Lower sand)
Perfs 1260-1300 (40 feet)
Sand 1227-1315
DTW = 103.05
WL = 5.95
Age = 18,000

W.R. Danskin, USGS, Revised, 3/4/04